
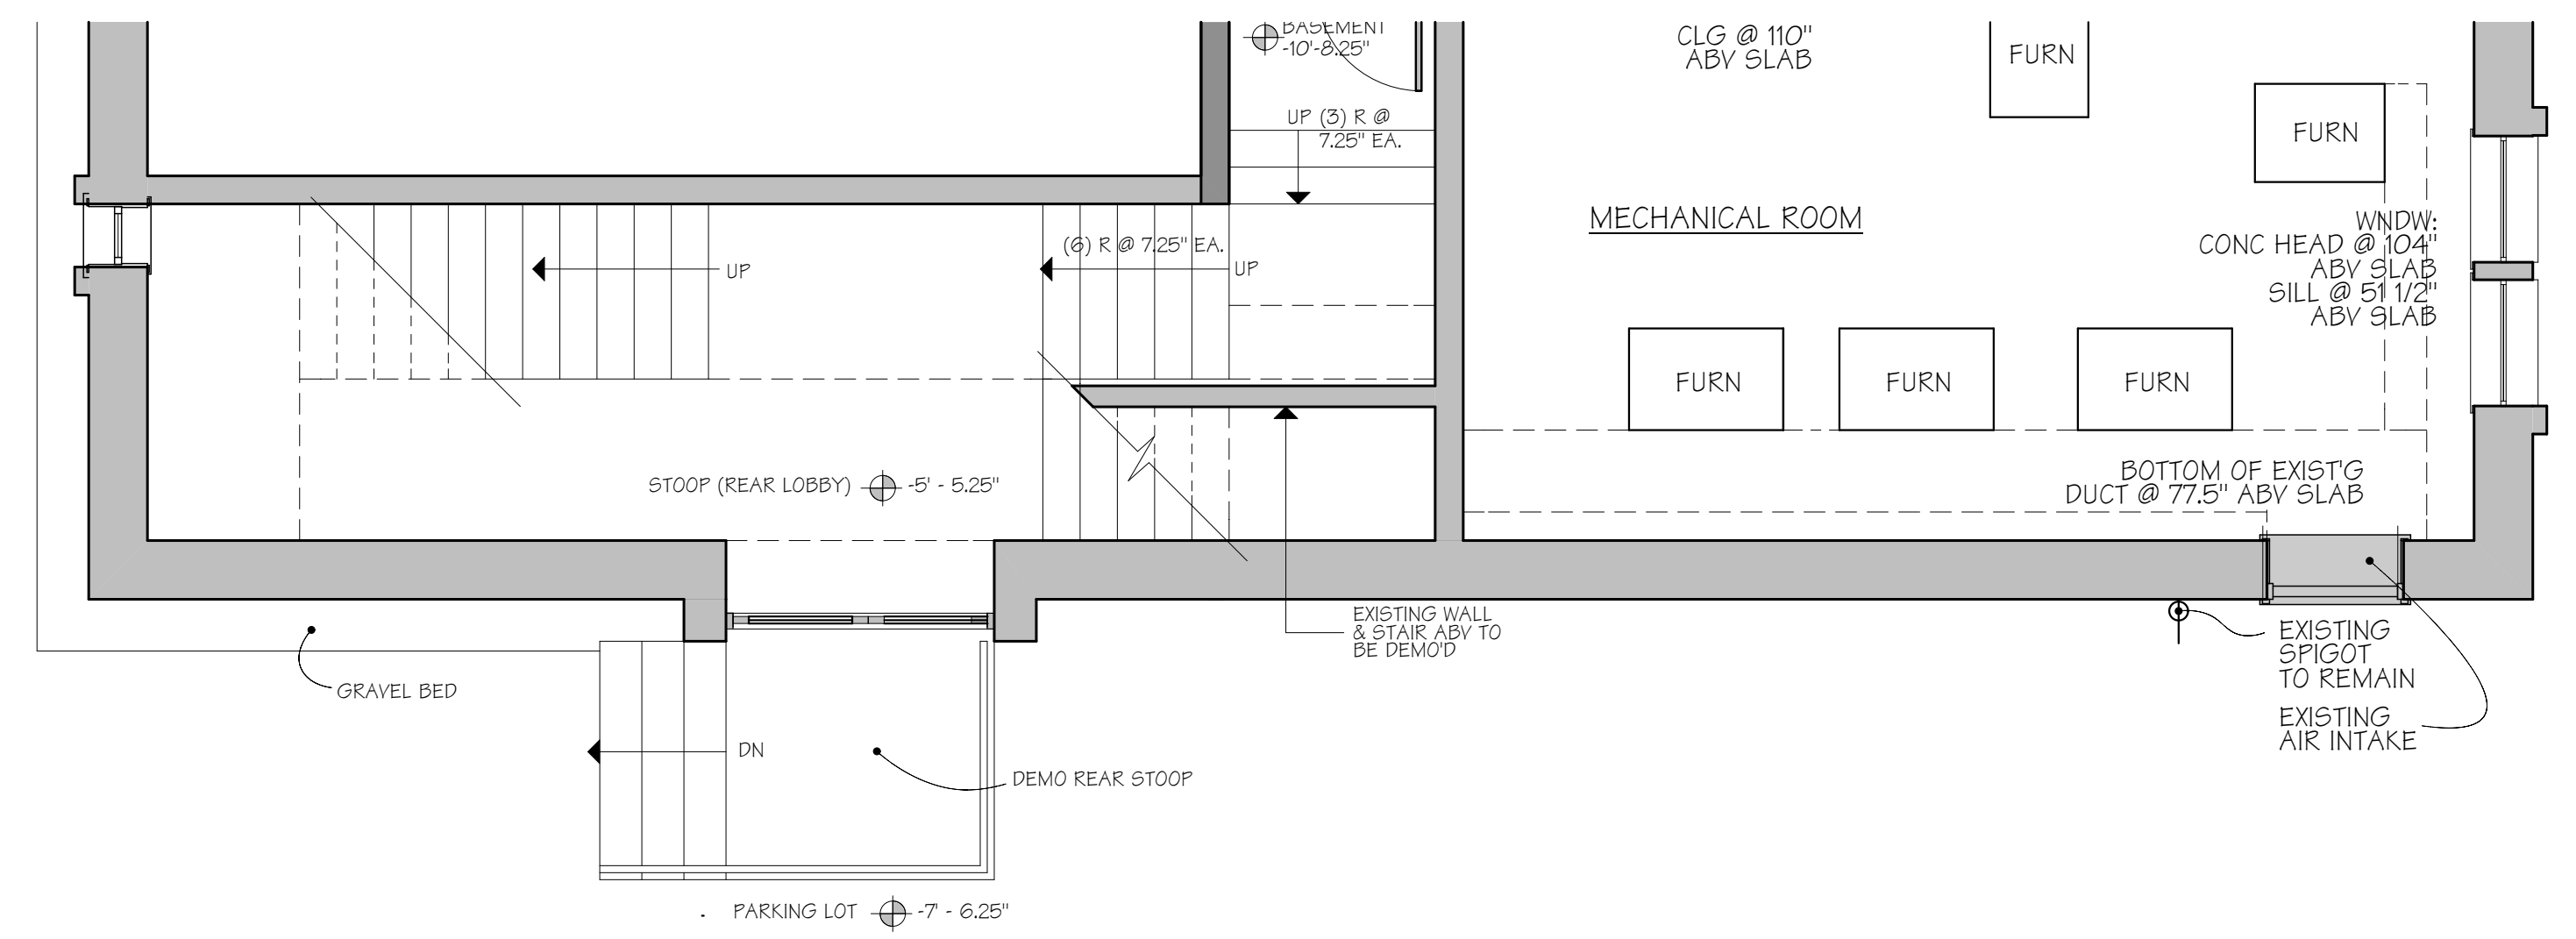


1 PLAN: FIRST FLOOR PROPOSED  
SCALE: 1/4" = 1'-0"

2 PLAN: FIRST FLOOR RCP  
SCALE: 1/4" = 1'-0"

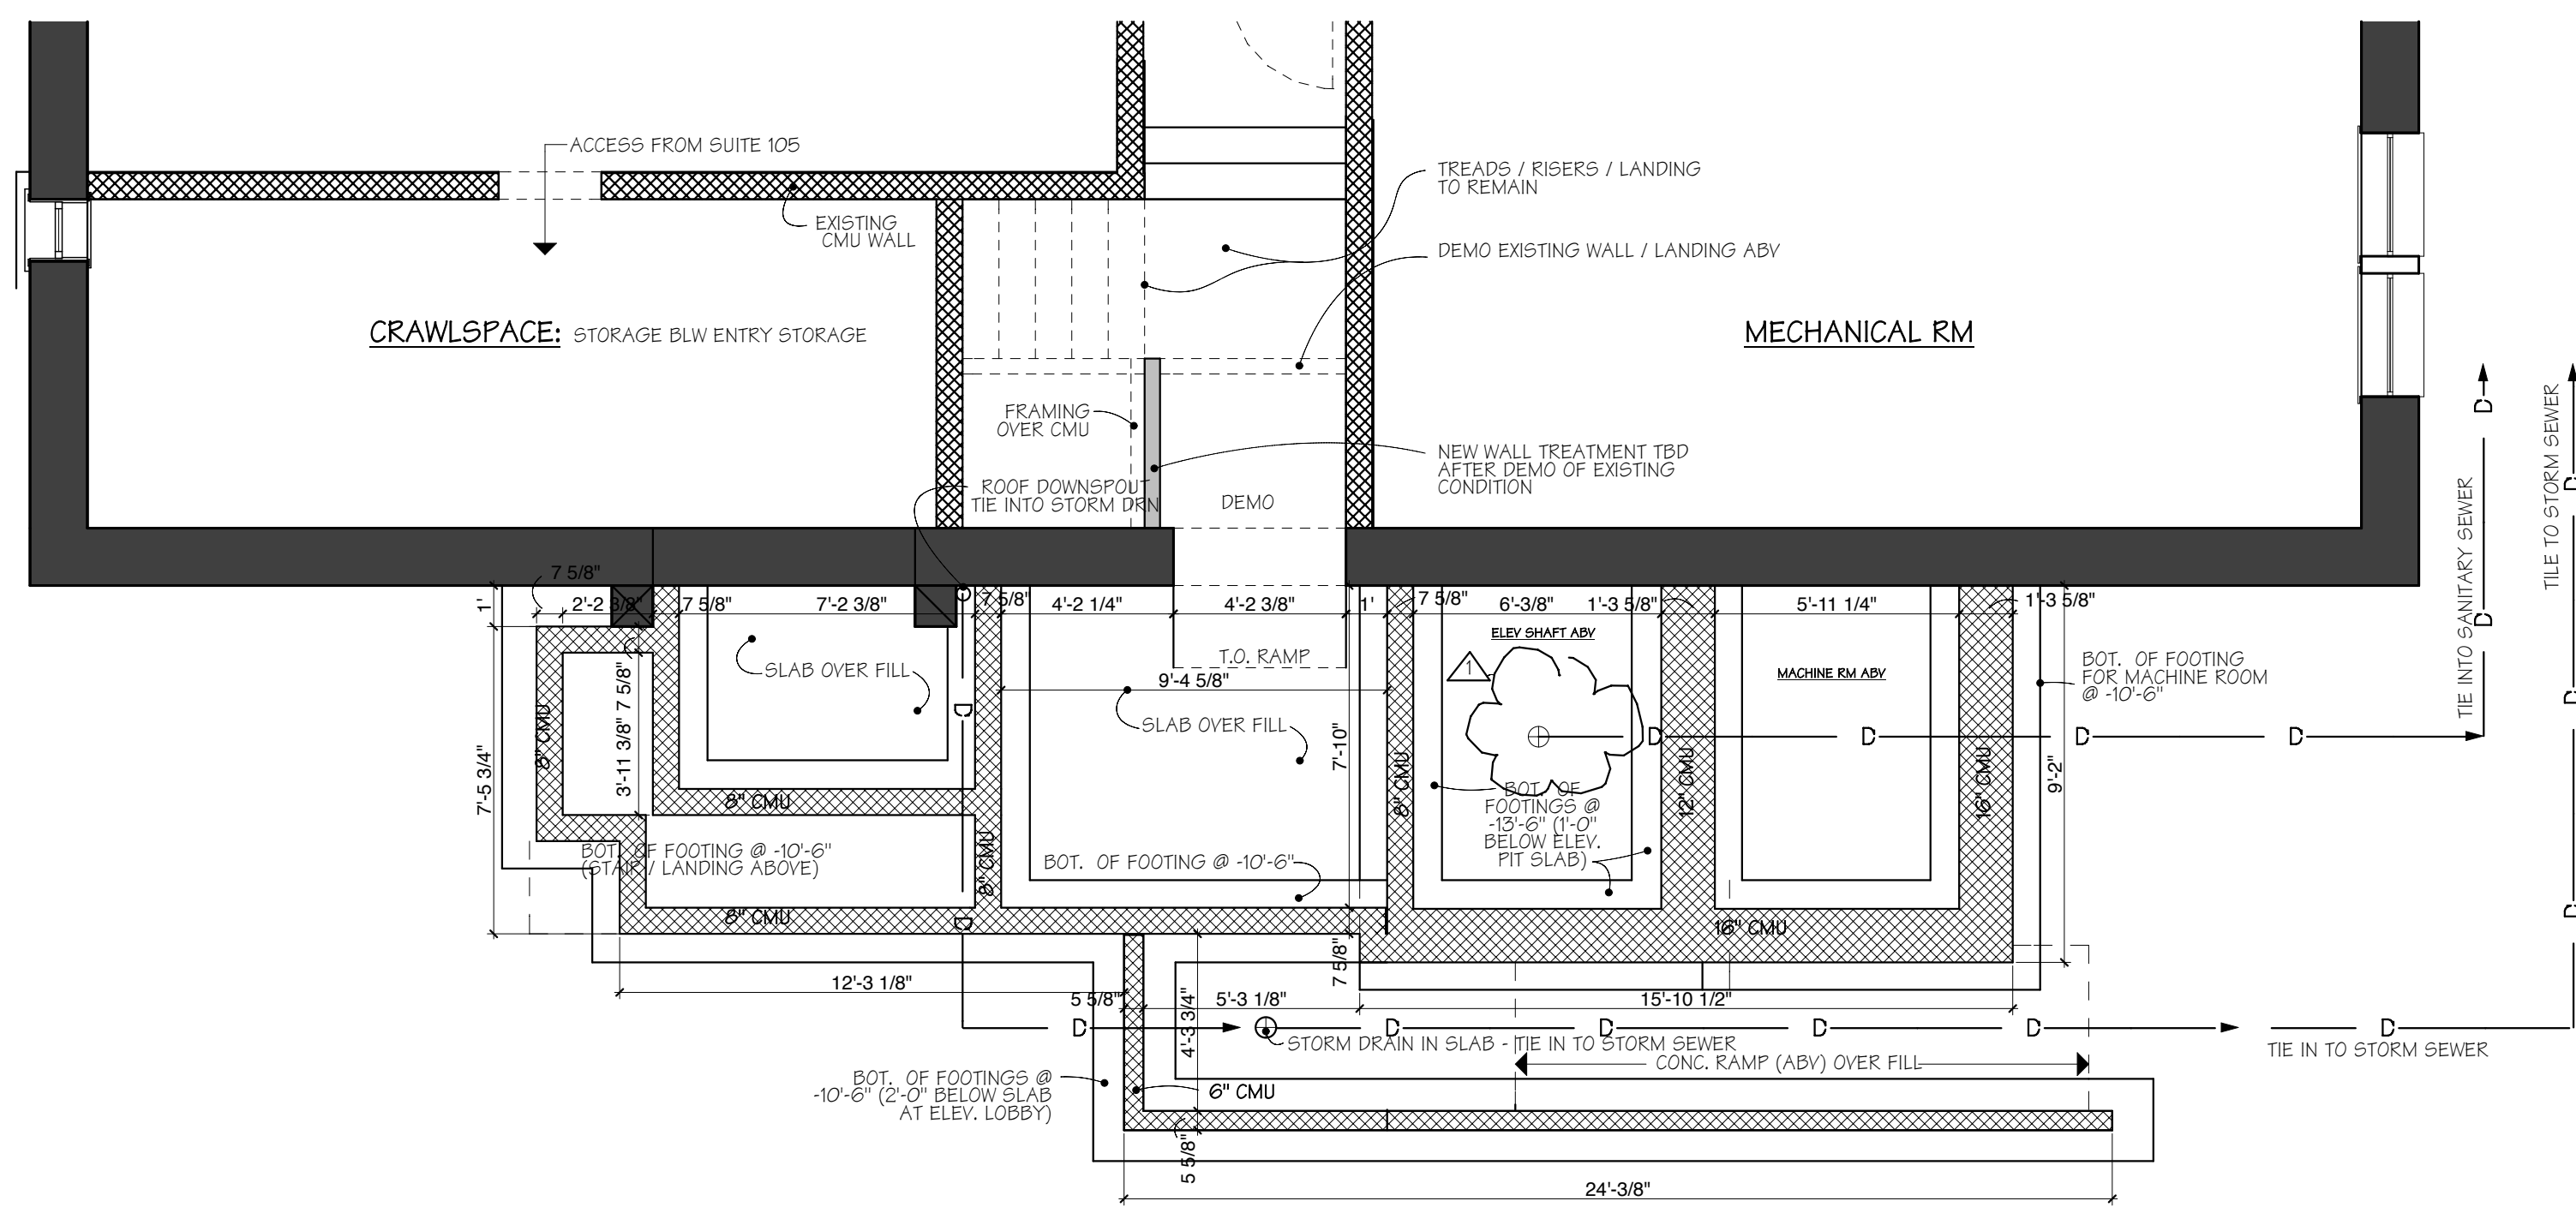

EXTERIOR ELEVATIONS 1 4 PLAN: FIRST FLOOR AS-BUILT / DEMO  
SCALE: 1/4" = 1'-0"