

WALL LEGEND

- EXISTING 12" CMU WITH BRICK VENEER TO REMAIN
- EXISTING 8" INTERIOR PARTITIONS TO REMAIN
- NEW 2x6 STEEL STUDS @ 16" O.C. WITH SPRAY FOAM INSULATION / STUCCO EXTERIOR
- NEW 8" X 16" CMU WITH 1" RIGID INSULATION AND 4" X 8" X 16" MASONRY VENEER
- NEW 8" X 16" STD GREY CMU WITH SCORE LINE WHERE VISIBLE @ ELEVATOR LOBBIES


SWITCHING LEGEND

- DIMMER SWITCH


LIGHTING LEGEND

SYMBOL	GENERIC DESCRIPTION	MODEL # / TRIM # / LAMP / NOTES
	RECESSED CAN LIGHTS	TB5
	WALL SCONCE	TB5
	SURFACE MOUNT ECONOMY FIXTURE	TB5

1 PLAN: THIRD FLOOR RCP
SCALE: 1/4" = 1'-0"

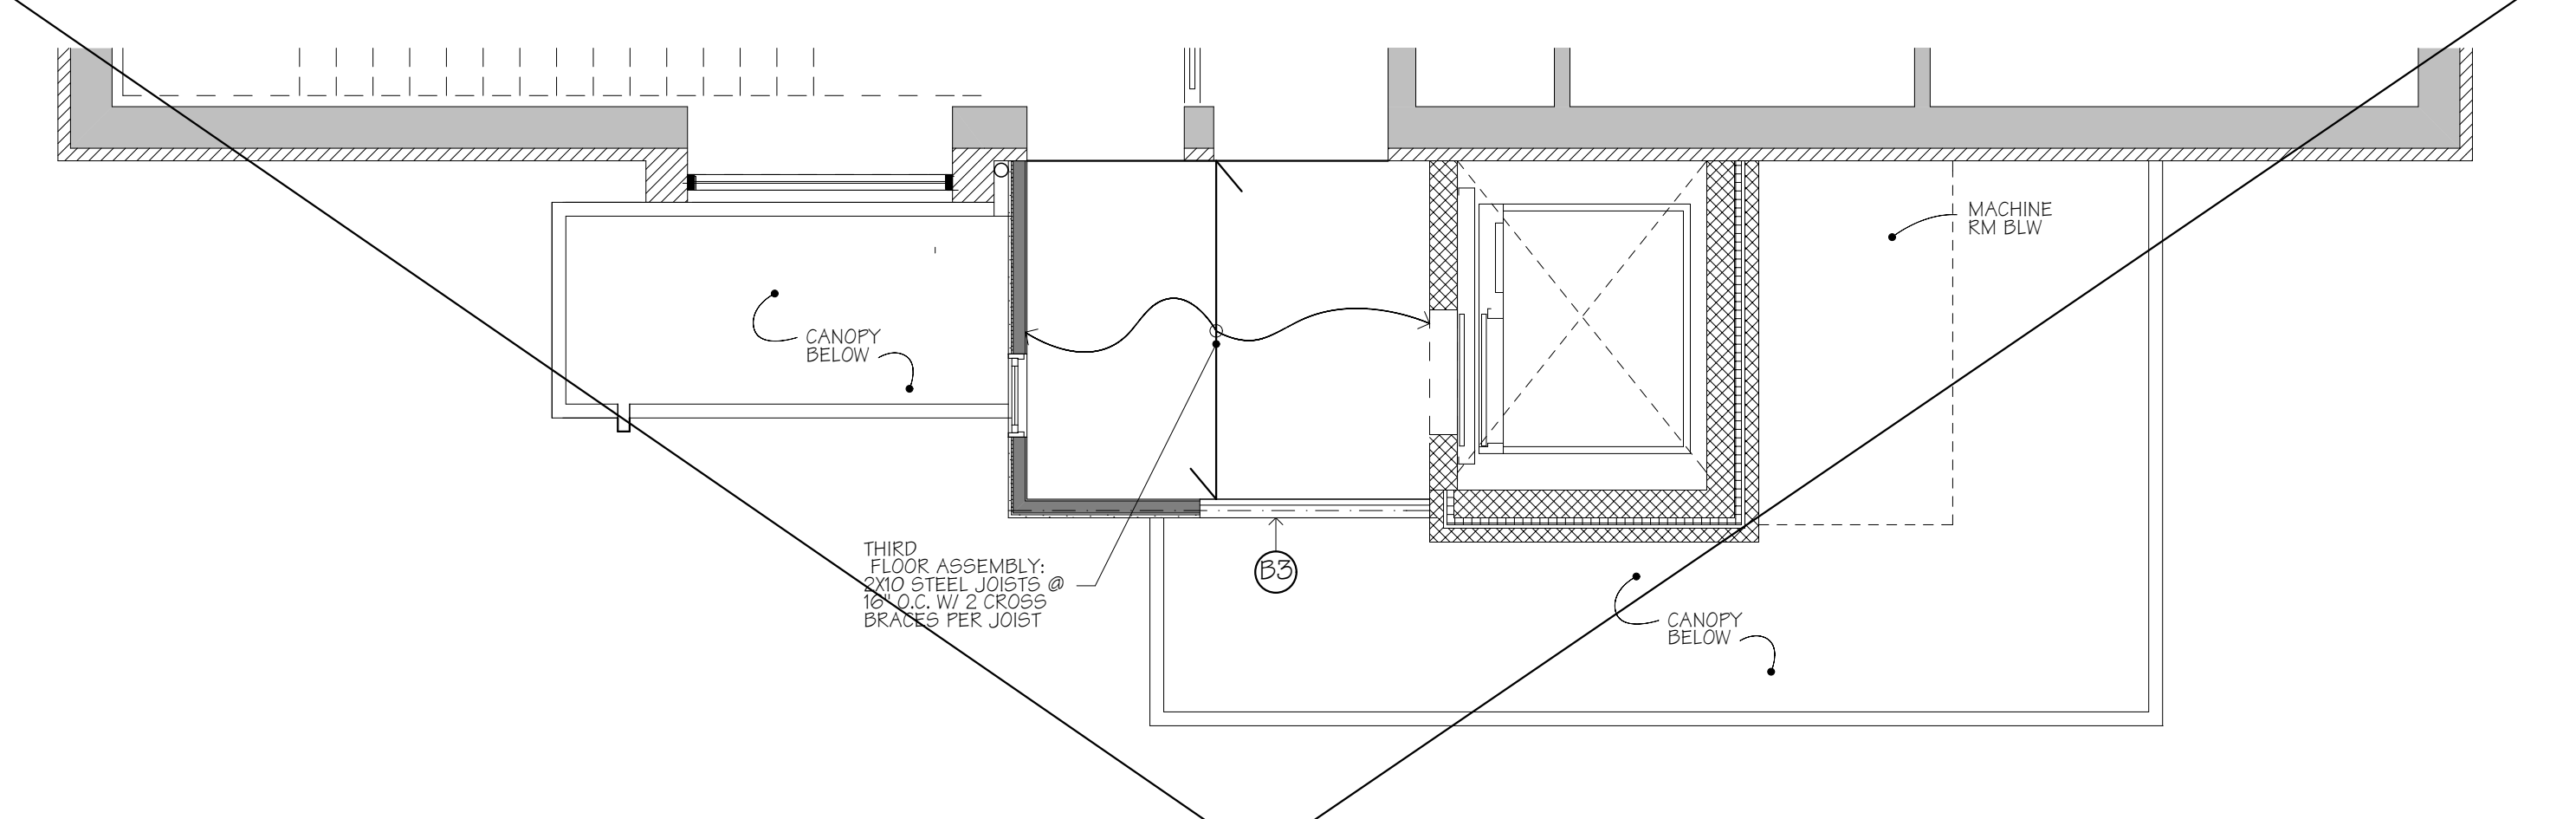


4 PLAN: THIRD FLOOR FRAMING
SCALE: 1/4" = 1'-0"

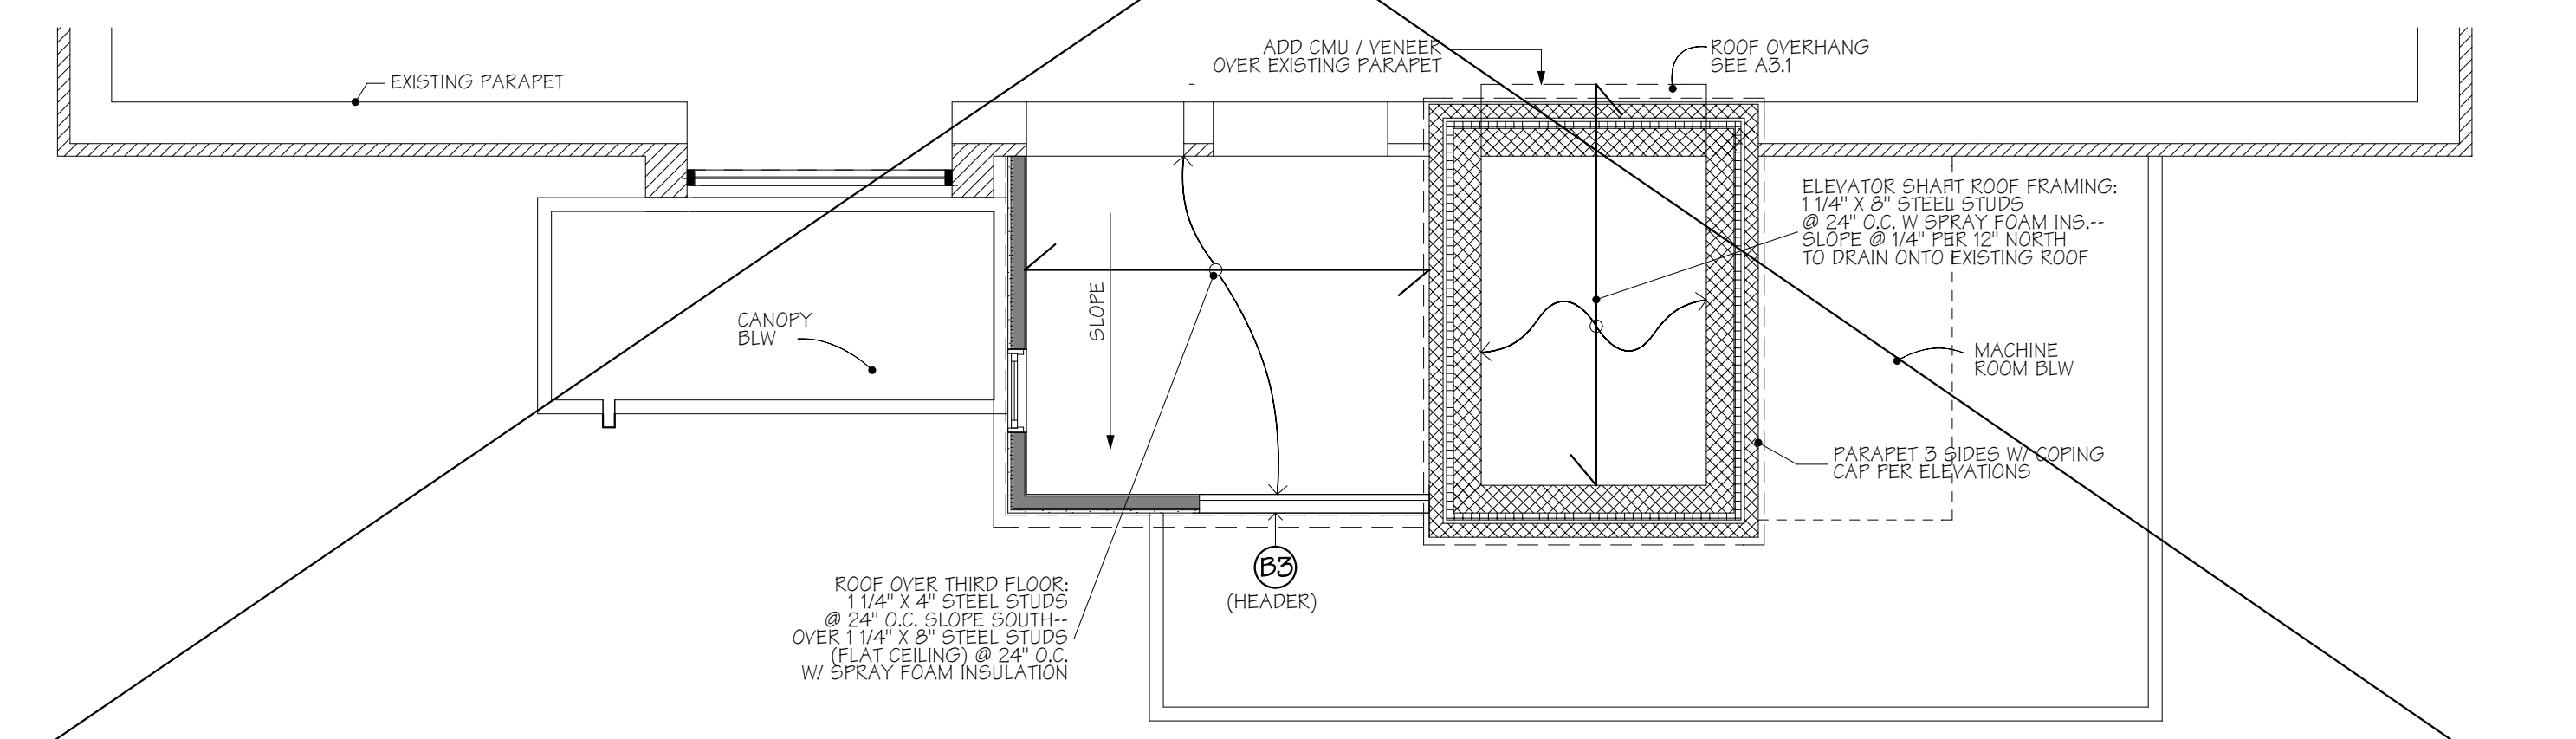

5 PLAN: ROOF FRAMING
SCALE: 1/4" = 1'-0"

2 PLAN: THIRD FLOOR PROPOSED (BFMJ)
SCALE: 1/4" = 1'-0"

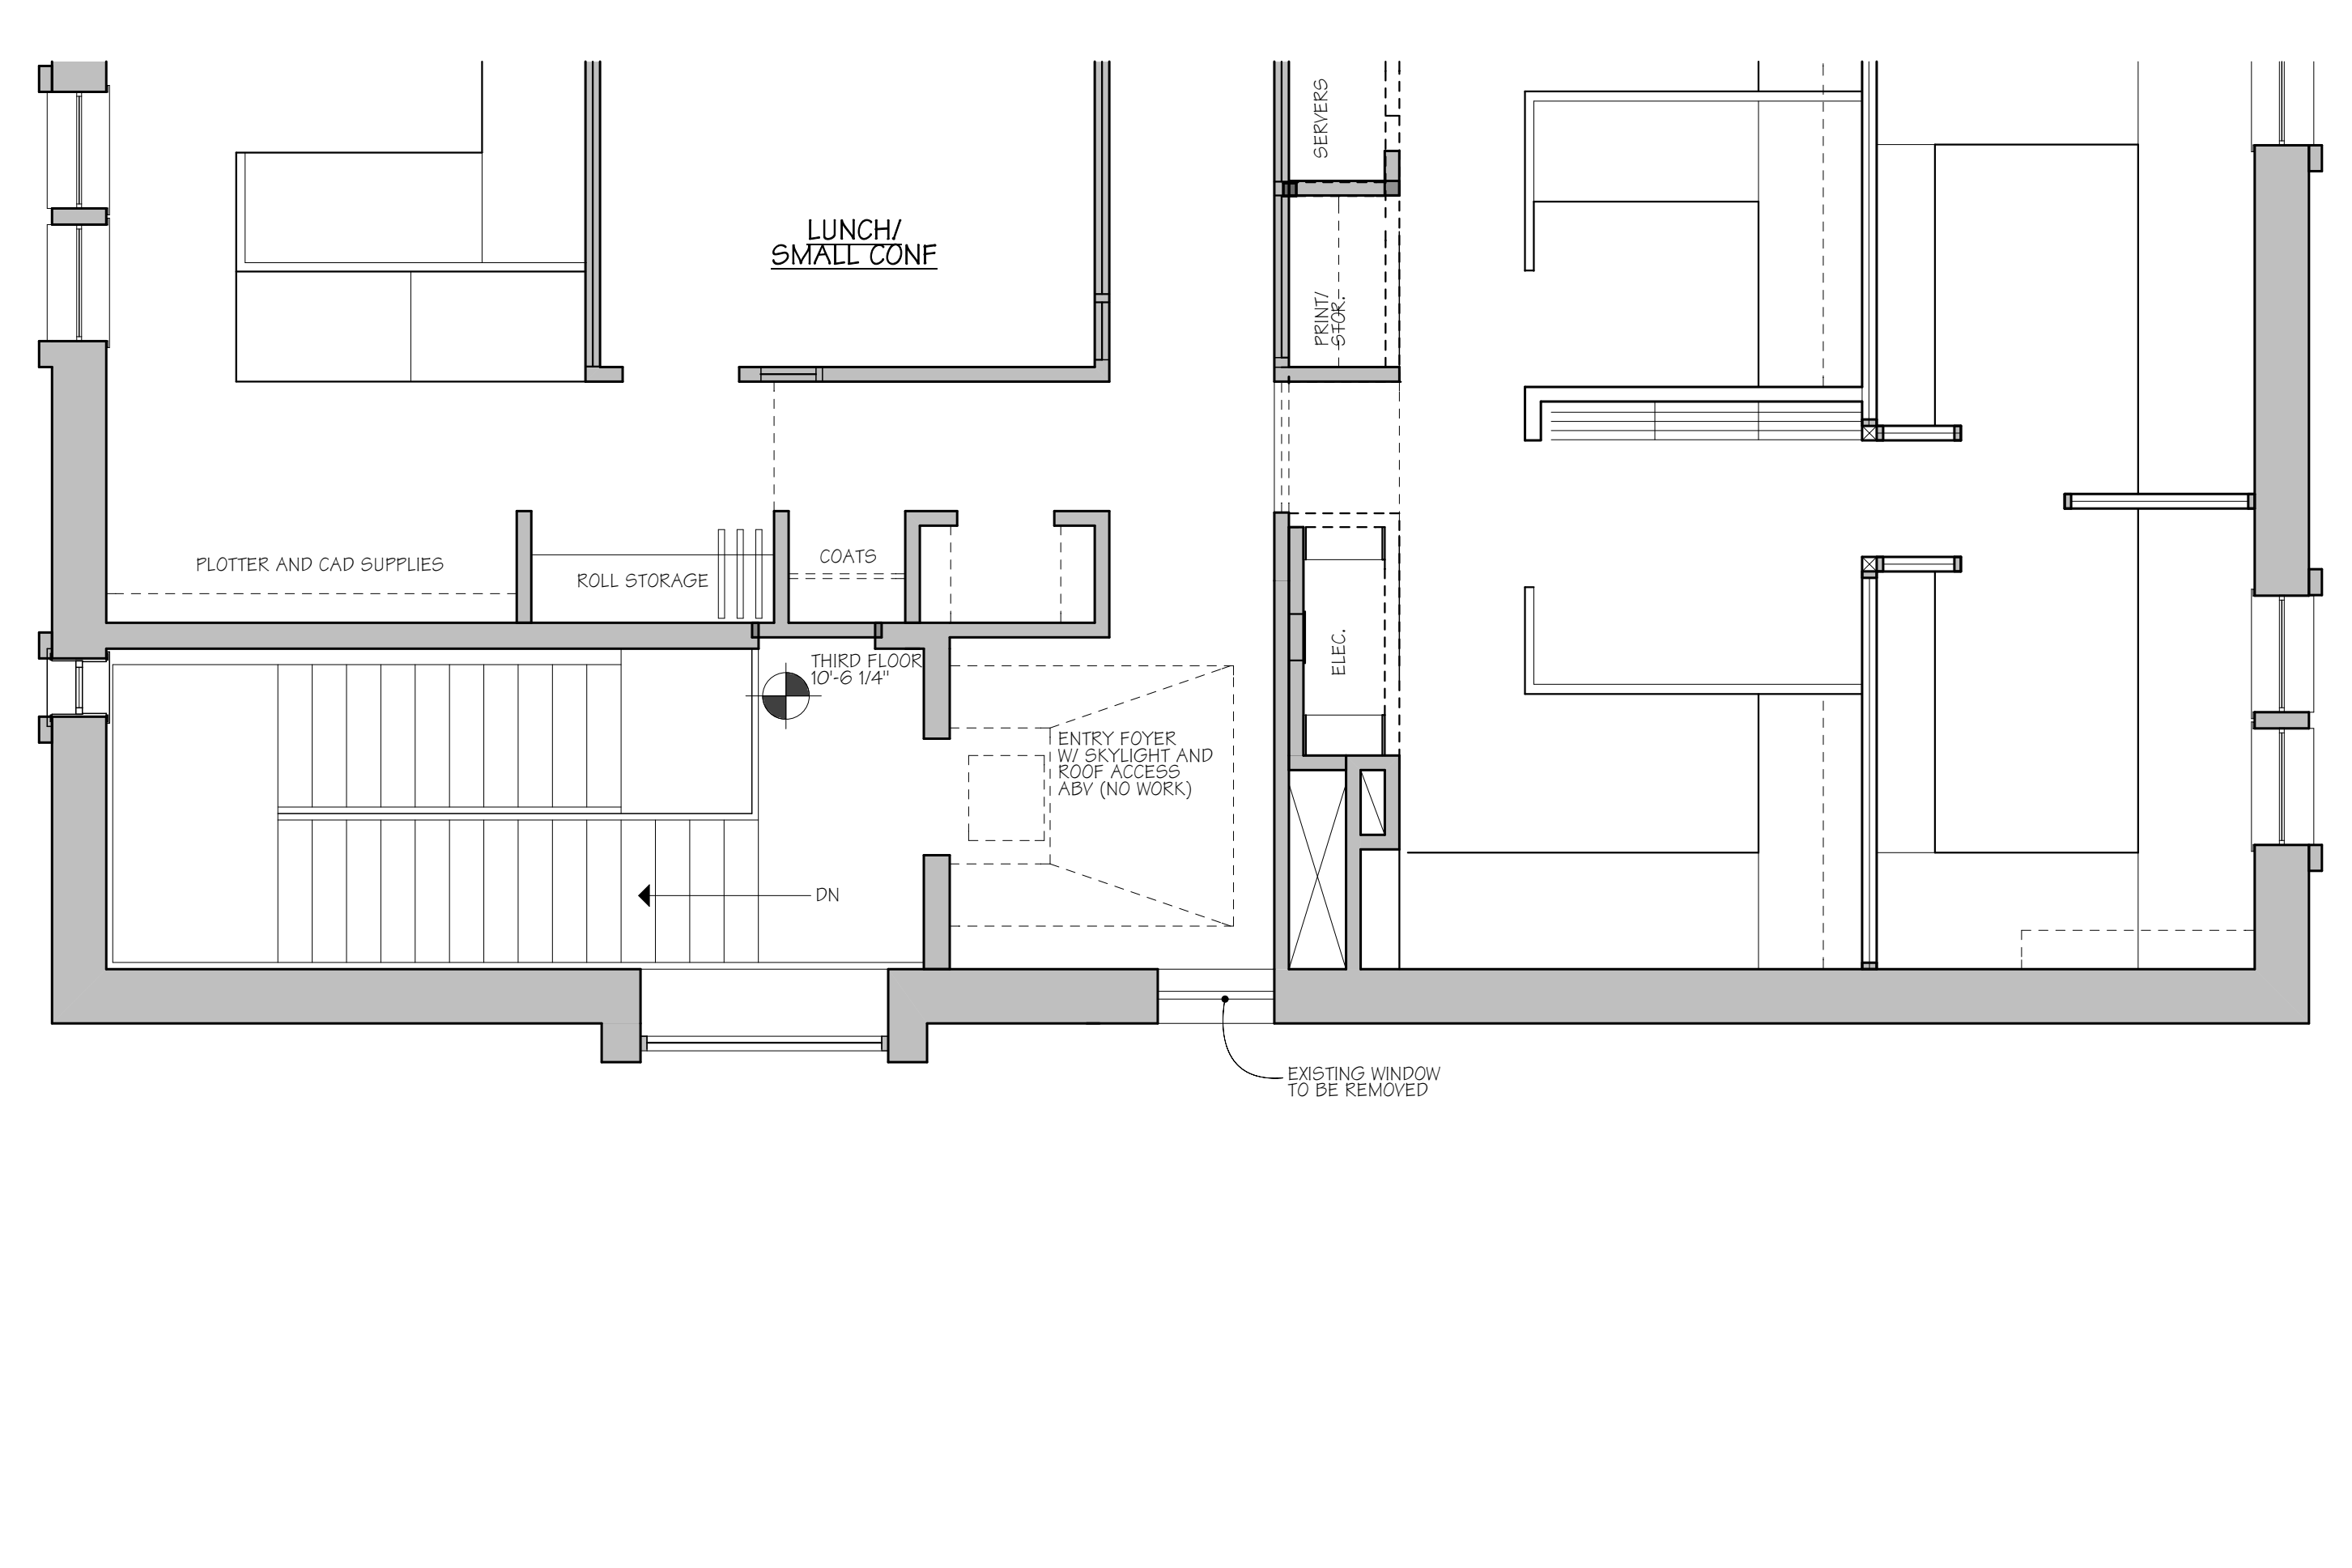

3 PLAN: THIRD FLOOR AS-BUILT
SCALE: 1/4" = 1'-0"